

AS-BUILT WW3 CASED WELL

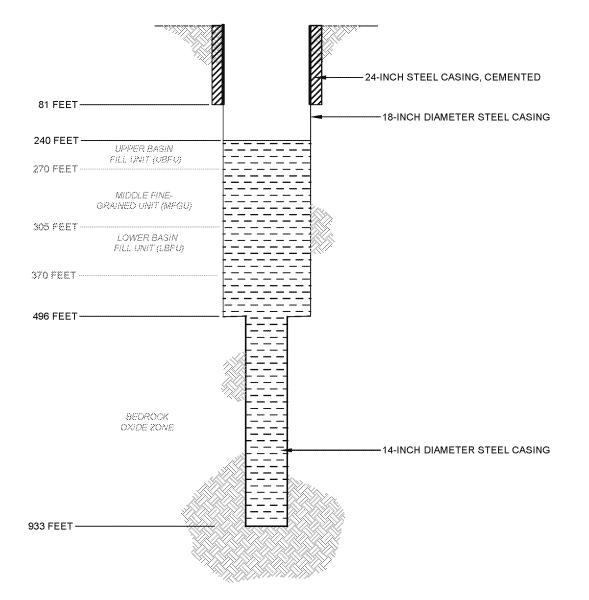

PROPOSED PLUGGING AND ABANDONMENT WW3 CASED WELL

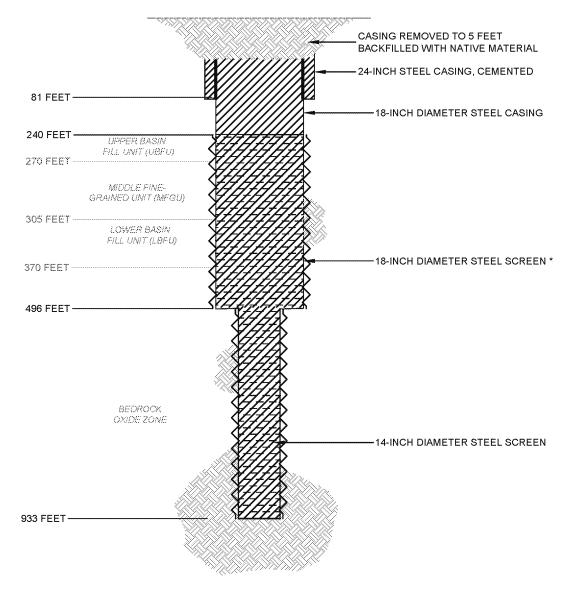

* WELL SCREEN WAS BRUSHED FROM 240 TO 496 FEET TO OPEN PERFORATIONS.



WW3 WELL ABANDONMENT SCHEMATIC

